


NOTES:

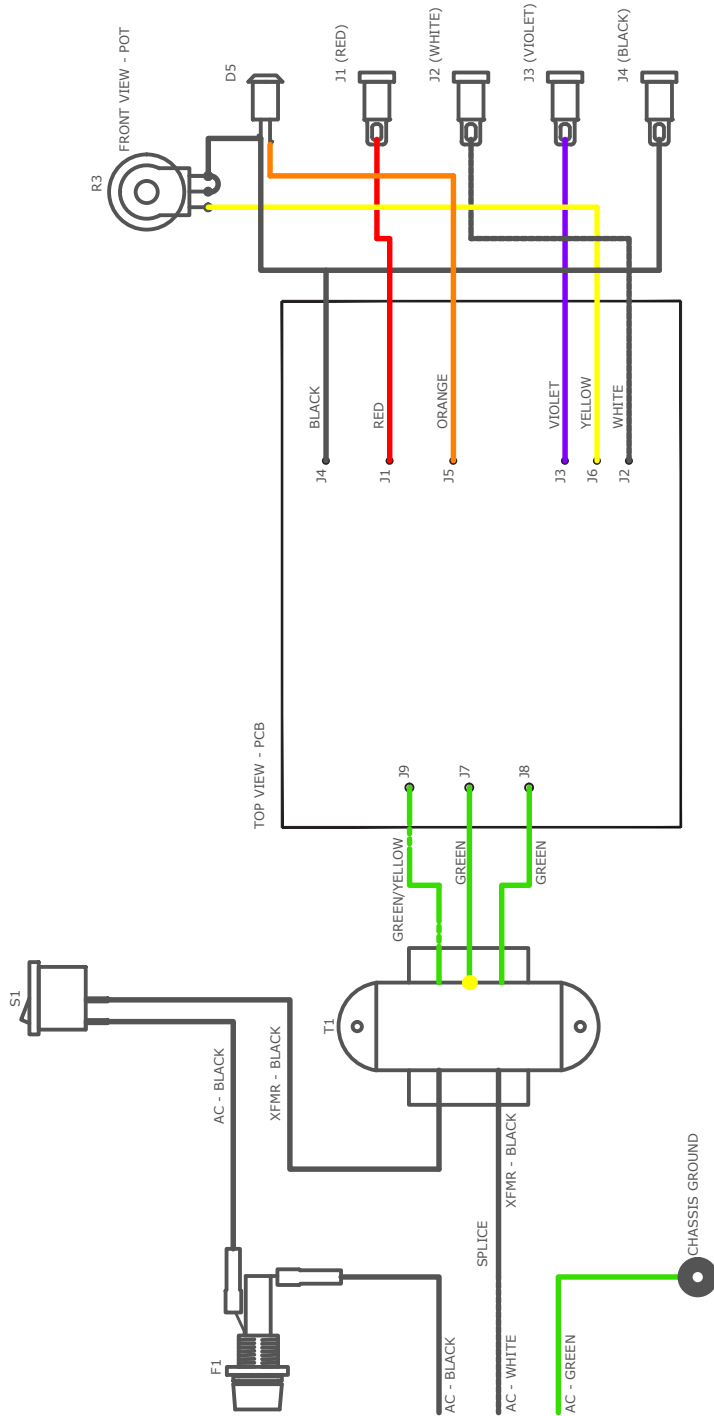

C			
B	AS BUILT	16/03/15	MLN
A	AS BUILT	14/02/24	MLN
-	PRELIMINARY	14/02/20	MLN
REV#	DESCRIPTION OF REVISION	DATE	APPR BY
BRITISH COLUMBIA INSTITUTE OF TECHNOLOGY			
TITLE DC POWER SUPPLY			
DRAWN BY: FILE NAME: 07-2B-Interconnect			
DATE: SHEET SIZE: A2			
CLASS SET: 14/02/22			
DRAWING No: INSTRUCTOR			
ID: 07-2			